



# THINKSPACE

15269 104 AVE, SURREY BC V3R 1N5



**INITIATION**

LASER SCANNED	<input checked="" type="checkbox"/>
NOT LASER SCANNED	<input type="checkbox"/>
HAND MEASURED	<input type="checkbox"/>
FROM EXISTING DRAWINGS	<input type="checkbox"/>

**SCANNER**

M.S.	<input checked="" type="checkbox"/>
TLS	<input type="checkbox"/>

**SCOPE OF WORK**

AS-BUILTS ONLY DRAWINGS	<input checked="" type="checkbox"/>
CONSTRUCTION DRAWINGS	<input type="checkbox"/>
MARKETING DRAWINGS	<input type="checkbox"/>
RENDERS	<input type="checkbox"/>
SURVEY	<input type="checkbox"/>
CLASH DETECTION	<input type="checkbox"/>

**CLIENT REQUIREMENTS**

FLOOR PLANS	<input checked="" type="checkbox"/>
ELEVATIONS	<input type="checkbox"/>
SECTIONS	<input type="checkbox"/>
REFLECTED CEILING PLANS	<input checked="" type="checkbox"/>
SITE PLAN	<input type="checkbox"/>
SURVEY	<input type="checkbox"/>
CLASH DETECTION	<input type="checkbox"/>


**BIM LEVEL OF DEVELOPMENT / TIER SYSTEM**

100	<input checked="" type="checkbox"/>
200	<input type="checkbox"/>
300	<input type="checkbox"/>
400	<input type="checkbox"/>
500	<input type="checkbox"/>

No.	DESCRIPTION	Date

**NOT FOR CONSTRUCTION**

**CONFIDENTIAL**

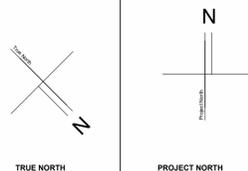

Project:  
SHERATON GUILDFORD HOTEL

Project Address:  
15269 104 AVE, SURREY BC V3R 1N5


Client:  
THINK SPACE

Drawing Title:  
COVER PAGE

Project No.:	01
Date:	N/A
Drawn:	HK
Checked by:	Checker
Drawing No.:	

**A00**

Scale:

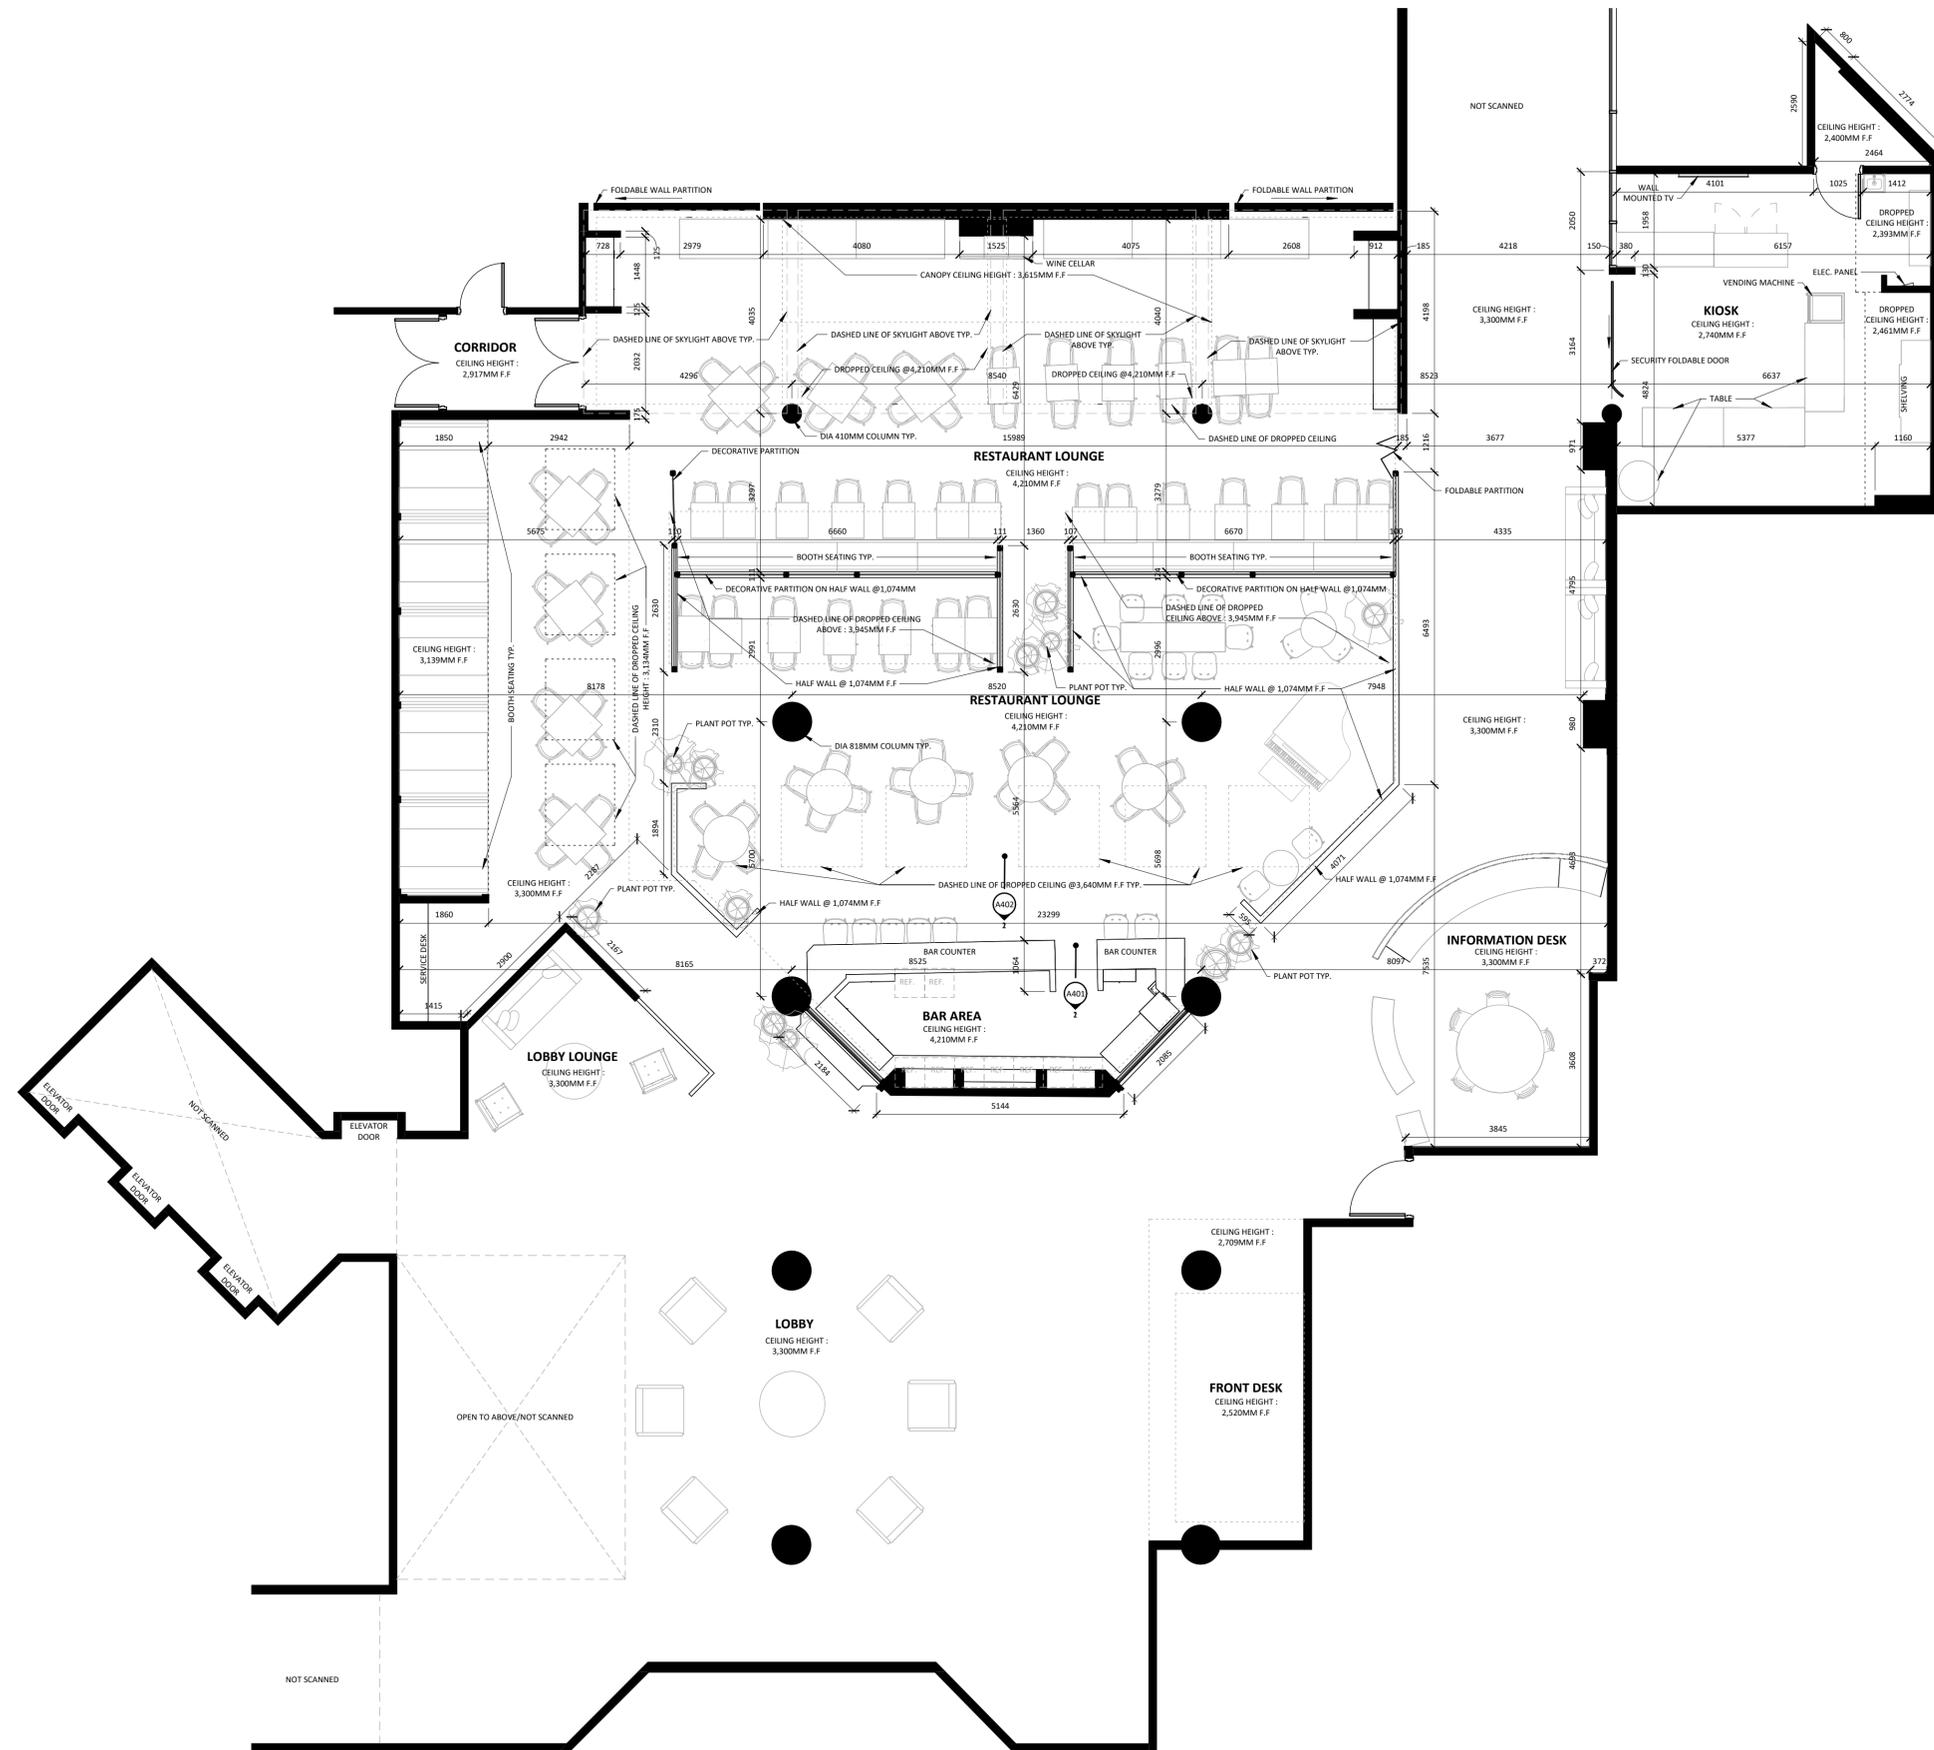

1 LEVEL 1 FLOOR PLAN  
 1:75

**INITIATION**

LASER SCANNED	
NOT LASER SCANNED	
HAND MEASURED	
FROM EXISTING DRAWINGS	

**SCANNER**

M.S.	
TLS	

**SCOPE OF WORK**

AS-BUILTS ONLY DRAWINGS	
CONSTRUCTION DRAWINGS	
MARKETING DRAWINGS	
RENDERS	
SURVEY	
CLASH DETECTION	

**CLIENT REQUIREMENTS**

FLOOR PLANS	
ELEVATIONS	
SECTIONS	
REFLECTED CEILING PLANS	
SITE PLAN	
SURVEY	
CLASH DETECTION	


**BIM LEVEL OF DEVELOPMENT / TIER SYSTEM**

100	
200	
300	
400	
500	

No.	DESCRIPTION	Date
-----	-------------	------

**NOT FOR CONSTRUCTION**

**CONFIDENTIAL**

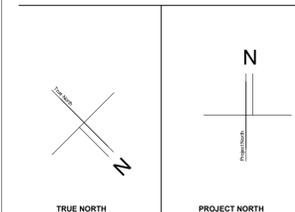

**Project:**  
 SHERATON GUILDFORD HOTEL

**Project Address:**  
 15269 104 AVE, SURREY BC V3R 1N5


**Client:**  
 THINK SPACE

**Drawing Title:**  
 LEVEL 1 FLOOR PLAN


Project No.:	01
Date:	N/A
Drawn:	HK
Checked by:	Checker
Drawing No.:	

**A101**

Scale: 1:75

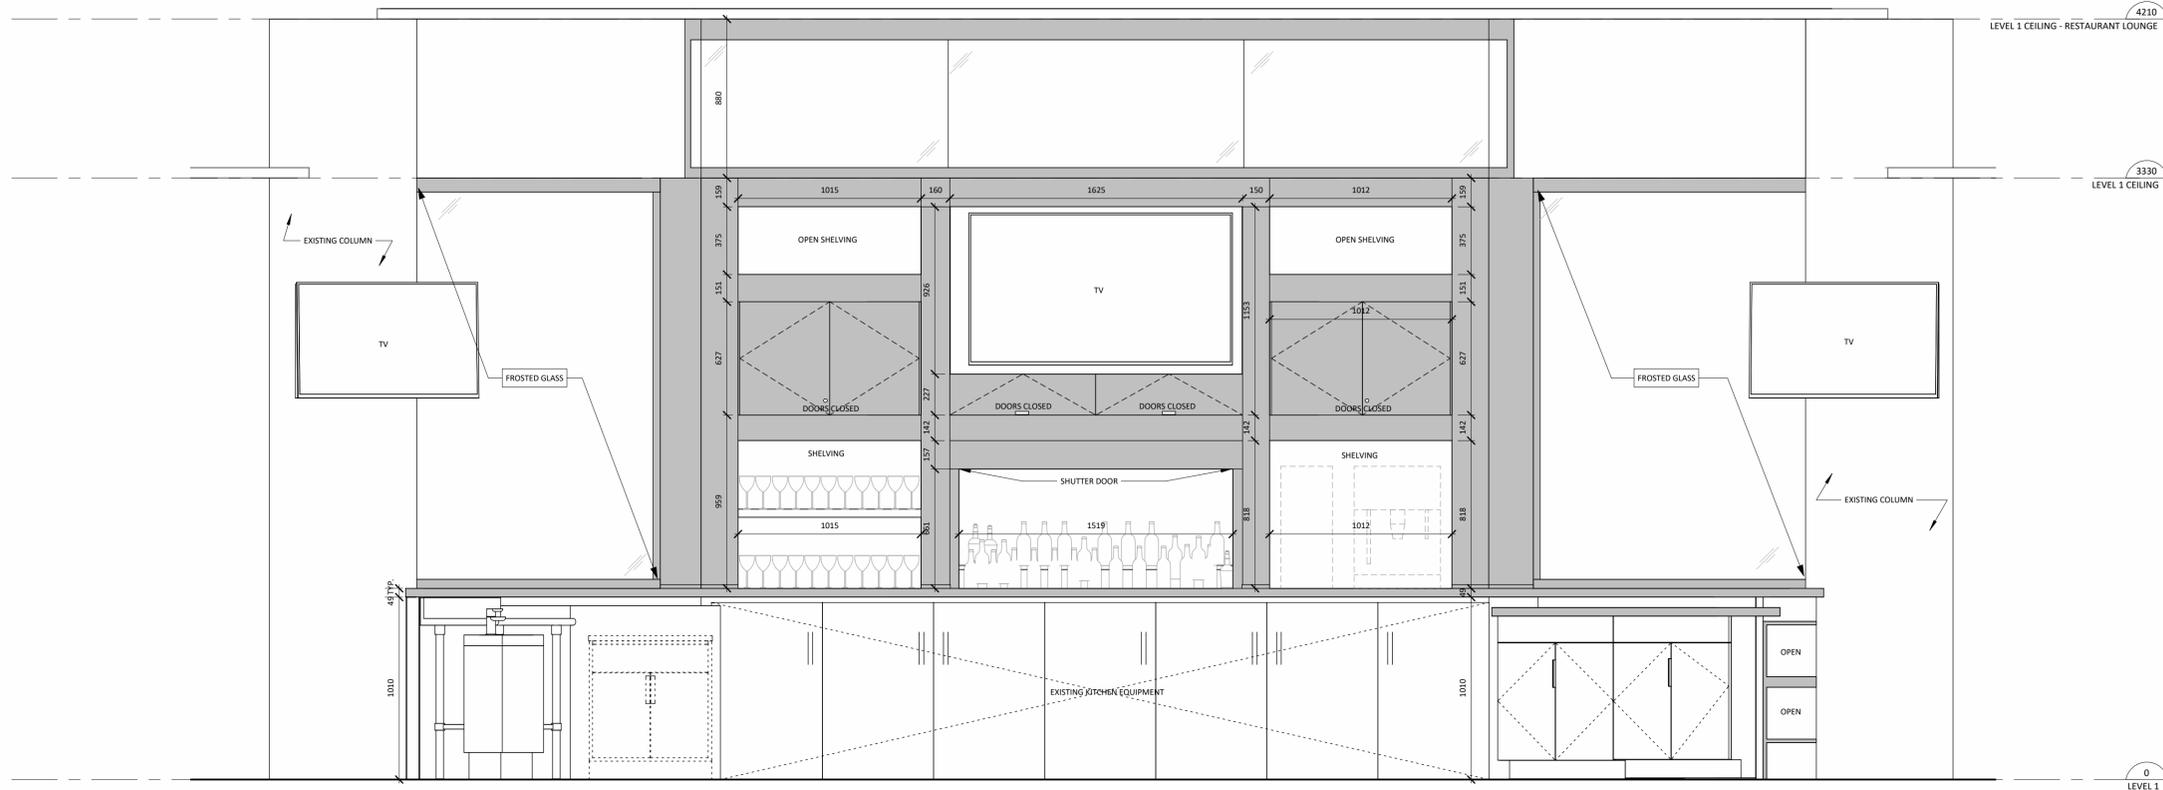

1 BACK OF BAR-ELEVATION  
1:20

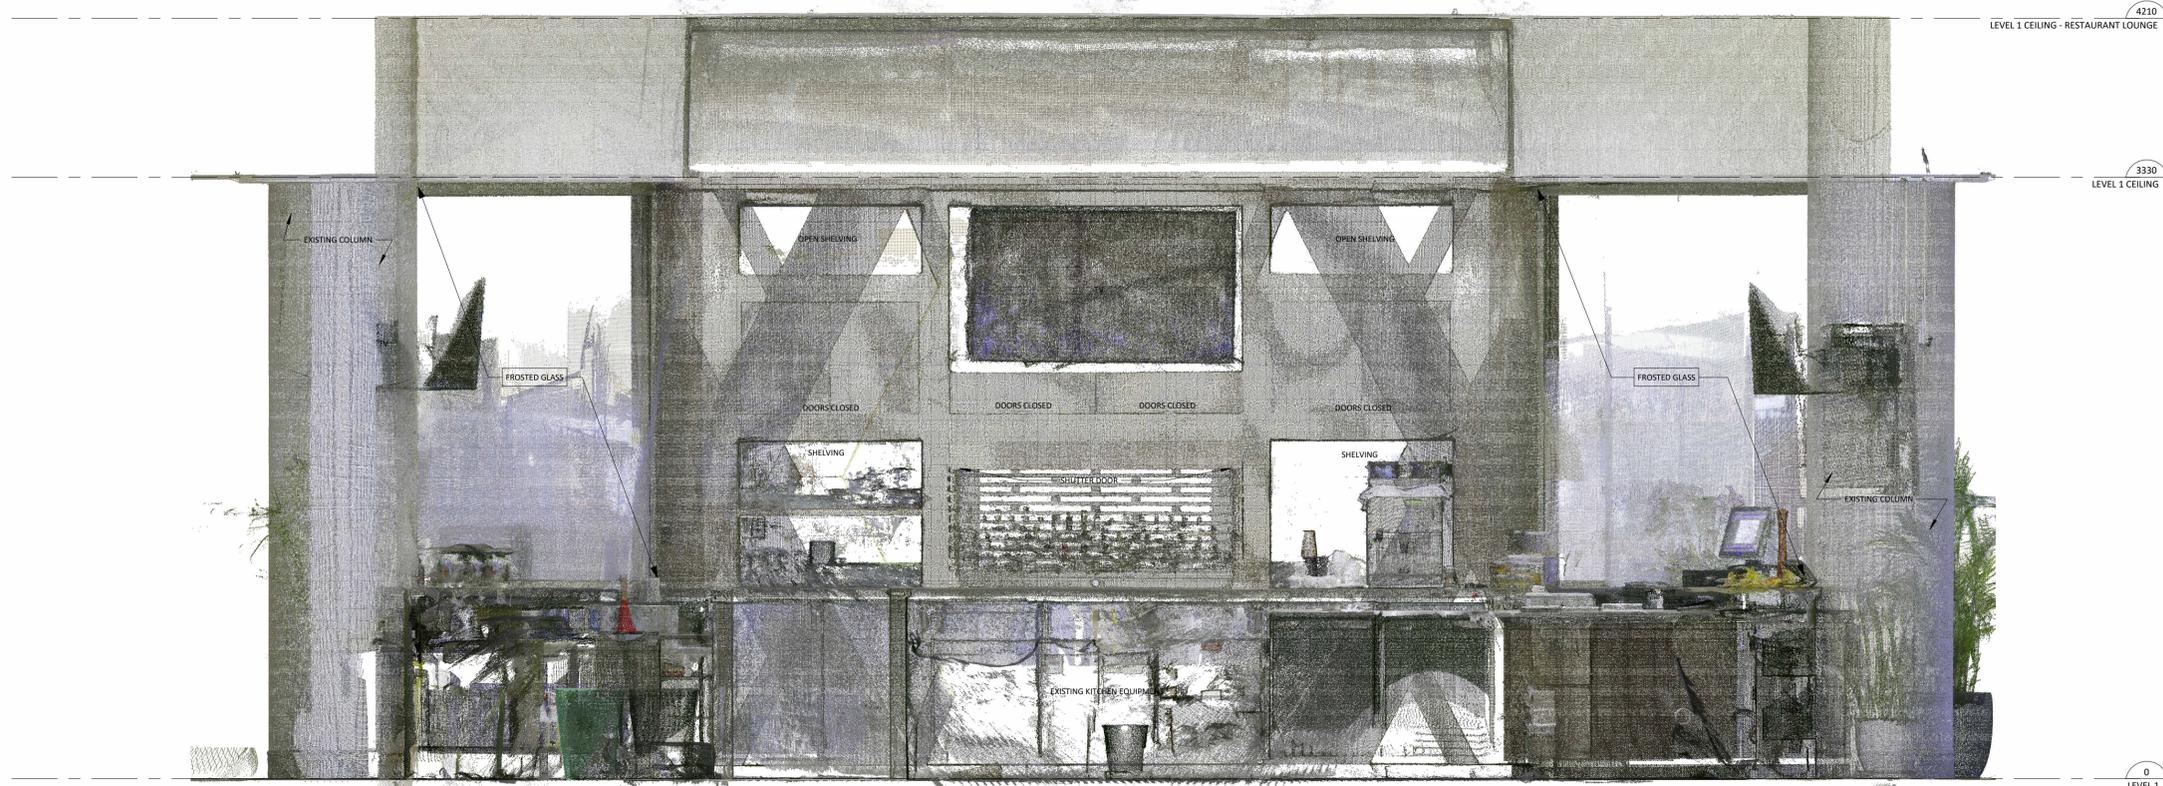

2 BACK OF BAR-ELEVATION (POINT CLOUD)  
1:20



**INITIATION**

LASER SCANNED	
NOT LASER SCANNED	
HAND MEASURED	
FROM EXISTING DRAWINGS	

**SCANNER**

M.S.	
TLS	

**SCOPE OF WORK**

AS-BUILTS ONLY DRAWINGS	
CONSTRUCTION DRAWINGS	
MARKETING DRAWINGS	
RENDERS	
SURVEY	
CLASH DETECTION	

**CLIENT REQUIREMENTS**

FLOOR PLANS	
ELEVATIONS	
SECTIONS	
REFLECTED CEILING PLANS	
SITE PLAN	
SURVEY	
CLASH DETECTION	


**BIM LEVEL OF DEVELOPMENT / TIER SYSTEM**

100	
200	
300	
400	
500	

No.	DESCRIPTION	Date

NOT FOR CONSTRUCTION

CONFIDENTIAL

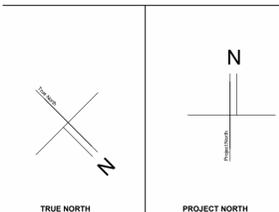

Project:  
**SHERATON GUILDFORD HOTEL**

Project Address:  
15269 104 AVE, SURREY BC V3R 1N5


Client:  
THINK SPACE

Drawing Title:  
**INTERIOR ELEVATION (BACK)**


Project No.:	01
Date:	N/A
Drawn:	Author
Checked by:	Checker
Drawing No.:	

**A401**

Scale: 1:20

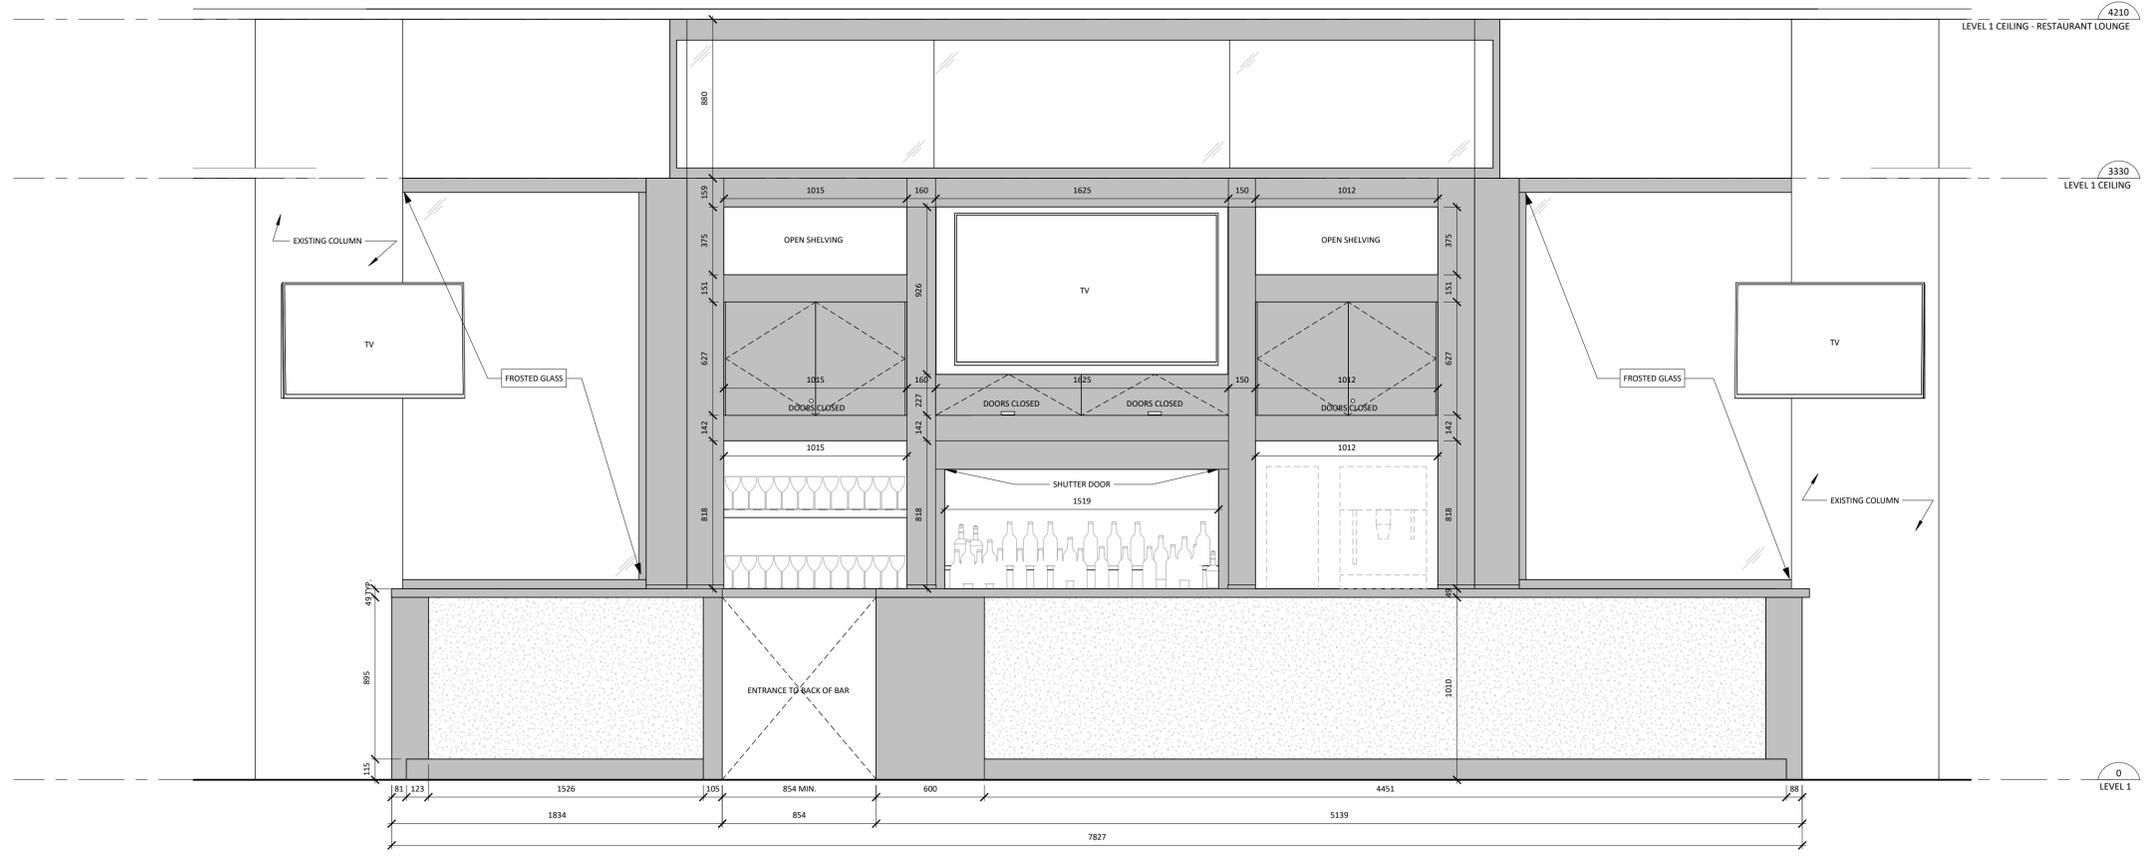

1 FRONT OF BAR - ELEVATION  
1:20

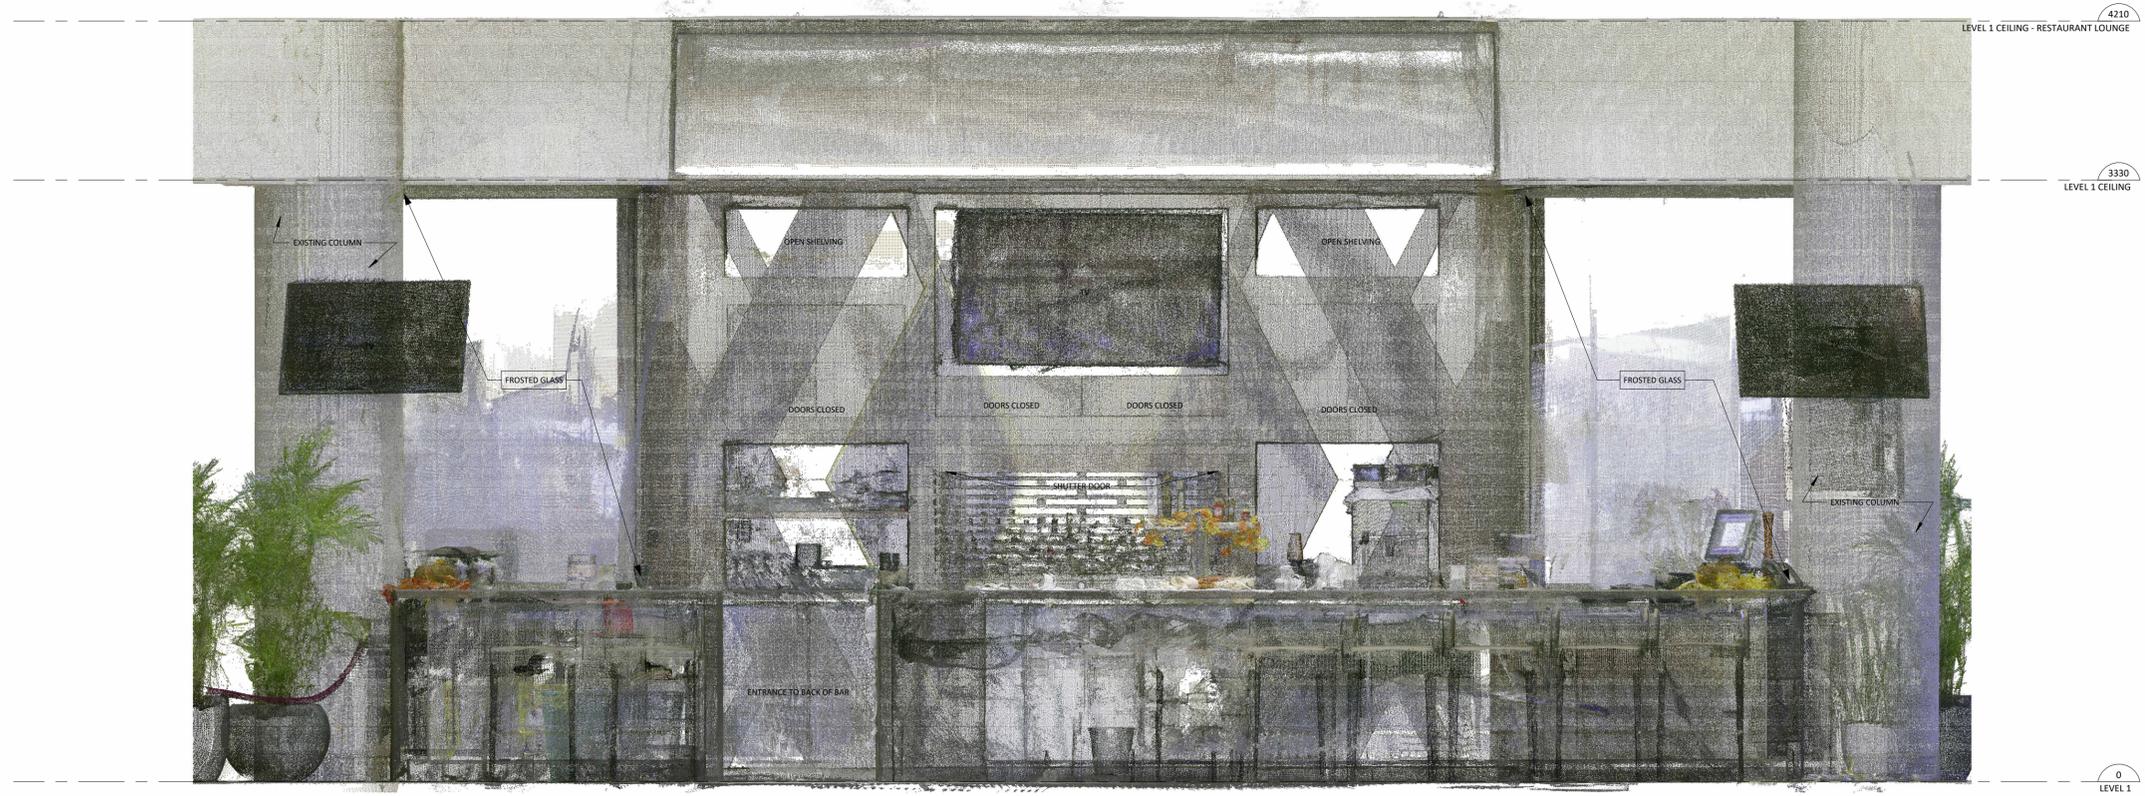

2 FRONT OF BAR - ELEVATION (POINT CLOUD)  
1:20



**INITIATION**

LASER SCANNED	
NOT LASER SCANNED	
HAND MEASURED	
FROM EXISTING DRAWINGS	

**SCANNER**

M.S.	
TLS	

**SCOPE OF WORK**

AS-BUILTS ONLY DRAWINGS	
CONSTRUCTION DRAWINGS	
MARKETING DRAWINGS	
RENDERS	
SURVEY	
CLASH DETECTION	

**CLIENT REQUIREMENTS**

FLOOR PLANS	
ELEVATIONS	
SECTIONS	
REFLECTED CEILING PLANS	
SITE PLAN	
SURVEY	
CLASH DETECTION	


**BIM LEVEL OF DEVELOPMENT / TIER SYSTEM**

100	
200	
300	
400	
500	

No.	DESCRIPTION	Date

**NOT FOR CONSTRUCTION**

**CONFIDENTIAL**

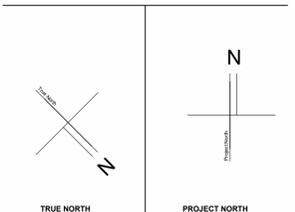

**Project:**  
SHERATON GUILDFORD HOTEL

**Project Address:**  
15269 104 AVE, SURREY BC V3R 1N5

**Client:**  
THINK SPACE

**Drawing Title:**  
INTERIOR ELEVATIONS (FRONT)

Project No.:	01
Date:	N/A
Drawn:	HK
Checked by:	Checker
Drawing No.:	

**A402**

Scale: 1:20